IN THE MATTER OF THE APPLICATION * OF MICHAEL E. MABRY, ET UX FOR A VARIANCE ON PROPERTY LOCATED ON THE NORTHWEST CORNER OF GLENCCE ROAD AND DABLINGTON DRIVE (2501 GLENCOE ROAD) 9th FLECTION DISTRICT

6th COUNCILMANIC DISTRICT

* COUNTY BOARD OF APPEALS * BALTIMORE COUNTY

* * * * * * * * * OPINION

* CASE NO. 89-133-A

This matter comes before this Board on an appeal from the Zoning Commissioner's denial of a variance permitting a front yard setback of 29 feet in lieu of 34.6 feet and a corner lot side setback of 21 feet in lieu of 25

Dr. Michael Mabry testified that the property was purchased in 1983 and currently exists in the same condition as when purchased. The portion of the property (dwelling) necessitating a variance was added by a previous owner in 1976.

Exhibits presented on behalf of Dr. Mabry indicated that the removal of the existing portions of the dwelling would create a practical difficulty for the Petitioner. This difficulty would be the cost of said removal, the diminution of the property's value and the lessening of the dwelling's living

There were no protectants at this hearing.

Therefore, the Board finds as a matter of fact that the Petitioner has shown that strict compliance would render compliance unnecessarily burdensome, that substantial injustice would result unless relief is granted and that the spirit of the ordinance will be observed and the public safety and welfare is

Variance to permit a front yard cotback of 29 feet in lieu of the required 19.6 feet and a corner lot side retback of 21 feet in lie, of the required to, four for existing improvements as some particularly described in Petin those to Exhibite 1 and 2, be and in hereby DMAIRD.

Robert Houses

Noning Conneissioner for
Baltimore County

Case No. 89-133-A Michael E. Mabry, et ux

Baltimore County

494-3353

J. Robert Haines

Zoning Commissioner

Zoning Commissioner

Office of Planning & Zoning

2501 Glencoe Road

Dr. & Mrs. Michael E. Mabry

Baltimore, Maryland 21234

(2501 Glencoe Road)

Case No. 89-133-A

Dear Dr. & Mrs. Mabry:

JRH:bjs

cc: Mr. Leonard Gilbert

People's Counsel

File

RE: PETITION FOR ZONING VARIANCE

NW/Corner Glencoe Road and Darlington Drive

Michael E. Mabry, et ux - Petitioners

in accordance with the attached Order.

Browne, Worrall & Johnson, Inc.

2435 N. Calvert Street Baltimore, Maryland 21218

9th Election District - 6th Councilmanic District

Towson, Maryland 21204

For the aforegoing reasons, it is this 11th day of May , 1989 by the County Board of Appeals of Ealtimore County CRDERED that a variance permitting a front yard setback of 29 feet in lieu of the required 34.6 feet and a corner lot side setback of 21 feet in lieu of the required 25 feet be and is hereby GRANTED.

Any appeal from this decision must be made in accordance with Rules B-1 through B-13 of the Maryland Rules of Procedure.

October 25, 1988

Enclosed please find a copy of the decision rendered in the

In the event any party finds the decision rendered is unfavor-

Very truly yours,

I. ROBERT HAINES

Baltimore County

Zoning Commissioner for

above-captioned matter. The Petition for Zoning Variance has been denied

able, any party may file an appeal to the County Board of Appeals within

thirty (30) days of the date of this Order. For further information on

filing an appeal, please contact Ms. Charlotte Radcliffe at 494-3391.


Dennis F. Rasmussen

COUNTY BOARD OF APPEALS

IN PE: PETITION FOR ZONING VARIANCE * EEFORE THE NW/Corner Glencoe Road and Darlington Drive (2501 Glencoe Road) 9th Election District 6th Councilmanic District Michael E. Mabry, et ux

> Fetilioners

* ZONING COMMISSIONER

* OF PALTIMORE COUNTY

* Cast No. 89-133-A

FINITINGS OF FACT AND CONCLUSIONS OF LAW

The Petitioners berein request a variance to permit a front yard metback of 29 feet in lieu of the required 34.6 feet and a corner lot side setback of 21 feet in lieu of the required 25 feet for existing improvements as more particularly described in Petitioner's Exhibits 1 and 2.

The Petitioners, by Leonard Gilbert, their Power of Attorney, appeared and testified. There were no Protestants.

Testimony indicated that the subject property, known as 2501 Glencoe Road, is zoned D.R. 5.5 and is improved with a single family dwelling. Testimony indicated that the Petitioners purchased the subject prop-Serty in 1983 and that at that time it was revealed the property did not meet current front and side yard zoning setback requirements. Petitioners did not tile the instant petition until August, 1988. By letter dated October 7, 1988 from the Petitioners, this office was advised that they would be out of town on the scheduled date and that they had appointed Mr. Glibert as their power of attorney to represent them at the hearing. Mr. dilbert was unable to testify as to the need for the variances requested and the practical difficulty and/or hardship which might be realized by the Petitloners without the requested variances.









THE UNDERSIGNED, purchasors and/or loan borrowers of the

captioned property, hereby acknowledge that I/we have been given

a copy of the attached survey and that I/we have been advised by

an owner's policy of title insurance, issued by Monumental Title

1) Subject to the location of the house, appartenant to the insured premises, located beyond the 25' building restriction

2) Subject to the location of the house, appurtenant to the

SECTION A, HARFORD PARK", which Plat is recorded among the Land Records of Baltimore County in Plat Book No. 16, folios 104, 105,

to the insured premises, located in the 10 foot right of way for

of survey by McKee & Associates, Inc., dated December 17, 1986.

sanitary sewer along the northern property line, as shown on plat

4) Subject to the location of the chain link fence, wood shed,

and concrete pad, appurtenant to the insured premises, located in

the 7.5 foot drainage easement along the western property line as

shown on plat of survey by McKee & Associates, Inc., dated

insured premises, which is located beyond the 30 foot sethack line,

3) Subject to the location of the chain link fence, appurtenant

Corporation, would contain exceptions regarding the following

line as shown on plat of survey by McKee & Associates, dated

as set forth on that Plat entitled "RESUBDIVISION, PART OF

the closing agent, at a time no later than final settlement, that

THIS PROBLEMS WERE BROUGHT UP AT SECTIONER TO FIRMEN PROBLEMS LINE EXENTED BY PROPERS CONTROL OR

rty is to be posted and advertised as prescribed by Zoning Regulations. ve, agree to pay expenses of above Variance advertising, posting, etc., upon filing of this

		I We do solemnly declare and a under the penalties of perjury, that are the legal owner(s) of the prowhich is the subject of this Petition.	I we
<i>.</i>	:rchaser:	Legal Owner(s):	MAP 15 16
	Print Name)	(Type or Print Name)	E. D/_/_
		Signature	200 (r)
		(Type or Print Name)	
	ale	Signature Signature	DP
	Petitioner:		
	int Name)	Address Phone No. **DIC AL 1828 C	
		City and State Name, address and phone number of legal owner, con-	
	. utale	Name Name 112 Annual Lange 192	
Attorney's Telephone No.:		6. 2 2.4th 2.41. 15.21.6	- 7 //7

13th day of Colober, 1958, at 2 o'clock.

PSTIMITED LENGTH OF HEARING (-1225. +188. AVAILABLE FOR CEASING MON./TUES./WED. - NEAT THO MINETED (over

PETITION FOR ZONING VARIANCE TO THE ZONING COMMISSIONER OF BALTIMORE COUNTY:

The undersigned, legal owner(s) of the property situate in Baltimore County and which is described in the description and plat attached hereto and made a part hereof, hereby petition for a Variance from Section 303.1, 1802.3.B (211.3) To allow a front setback of 29 ft. and a corner lot side setback of 21 ft. in

lieu of the required 34.6 ft. front yard average and 25 ft. of the Zoning Regulations of Baltimore County, to the Zoning Law of Baltimore County; for the following reasons: (indicate hardship or practical difficulty)

AMARINE Smet.

id further agree to and are to be bound by the zoning regulations and restrictions of County adopted pursuant to the Zoning Law For Baltimore County.

	4
AP / //	
36	
o. 7th	
ATE 4-7-5 1	
x	
xxx <u>1/ F</u>	Last Call
·	2
<i>:</i>	
1/1 -	
<i>191</i>	
5 -	a
ζ	

Witness M. Mael E. Malry

MICHAEL E. MABRY

Witness Michael E. Malry

MICHAEL E. MABRY

MICHAEL E. MABRY

MICHAEL E. MABRY

AS SWORN TO and subscribed before me this 17th day of February, 1987.

NOTARY PUBLIC

My Commission Expires: July 1, 1990.

APP #: 195730-B

matters:

and 106.

December 17, 1986.

December 17, 1986.

PROPERTY: 2501 Glencoe Road



Attached to and made a parof a Deed of Trust from MICHAELEN C. MABRY and HELEN C. MABRY, husband and wife, to the Trustees for MARYLAND NATIONAL MORTGAGE CORPORATION.

SCHEDULE " A "

BEING KNOWN AND DESIGNATED as Lot No. 1, Block 36 as shown on a Plat entitled, "Resubdivision of Part of Section A, HARFORD PARK", which Plat is recorded among the Land Records of Baltimore County in Plat Book RRG 30, folio 72 (erroneously referred to as GLB 16, folios 104, 105 and 106). The improvements thereon being known as No. 2501 Glencoe

SAVING AND EXCEPTING therefrom so much thereof as was conveyed by Deed from Henry W. Foster, et al, to Nicholas B. Mangione and wife by Deed dated April 21, 1965 and recorded among the Land Records of Baltimore County in Liber RRG No. 4467 folio 1.

CERTIFICATE OF PUBLICATION

NALES & LEGAL NOTICES TOWSON, MD., 19 NOTICE OF HEARING The Zoning Commissioner of Baltimore County, by authority of the Zoning Act and Regulations of Baltimore County with hold a THIS IS TO CERTIFY, that the annexed advertisement was public hearing on the property identified herein in Room 106 of the County Office Building, lo-cated at 111 W. Chesapeake Av-enue in Towson, Maryland as folpublished in THE JEFFERSONIAN, a weekly newspaper printed and published in Towson, Baltimore County, Md., once in each Petition for Zoning Variance of _____ successive weeks, the first publication appear-Darington Drive (2501 Giencoe Road) oth Election District Petitioner(s): Michael E. Mabry, et ux THE JEFFERSONIAN, Variance to allow a setback of quired 34 6 foot front yard aver-In the event that this Petition is In the event that this Petition is granted, a building permit may be issued within the thirty (30) day appeal period. The Zoning Com-missioner will, however, entertain any request for a stay of the is-suance of said permit during this ------Publisher

and received in this office by the date of the hearing set above or

J. ROBERT HAINES Zoning Coram anoner of Baltimore County

Variance to allow a subject of 29 ft. and a corner for side setback of 21 feet in lieu of the required 34 6 foot front yard average and 25 feet, respectively. In the event that this Petron is granted, a building permit may be issued within the thirty (30) day appeal penod. The Zorung Commissioner wit, however, entertain any request for a stay of the issuance of said permit during this penod for good cause shown. Such request must be in writing and received in this office by the date of the hearing set above or presented at the hearing.

_ J. ROBERT HAINES

Zoning Commissioner of Baltimore County N-359 Sept. 14

CERTIFICATE OF PUBLICATION

THIS IS TO CERTIFY, that the annexed advertisement was published in THE JEFFERSONIAN, a weekly newspaper printed and published in Towson, Baltimore County, Md., once in each successive weeks, the first publication appear-The hometic road.

CERTIFICATE OF POSTING ZONING DEPARTMENT OF BALTIMORE COUNTY

Petitioner: Mickey E. Mabry of all Location of property: NW/cor. Gloncos Rd & Darling for Onits 1501 Chances Ad. Location of Signer Facing Chopen Ad, approx 15' Fr road way on fro party of Etitioner Date of return: 12/16/77 Posted by It Stinley Number of Signs:



County Board of Appeals of Baltimore County

COUNTY OFFICE BUILDING 111 W. CHESAPEAKE AVENUE TOWSON, MARYLAND 21204 (301) 494:3180 887-3180

HEARING ROOM -Room 301, County Office Building

January 26, 1989 NOTICE OF ASSIGNMENT

NO POSTPONEMENTS WILL BE GRANTED WITHOUT GOOD AND SUFFICIENT REASONS. REQUESTS FOR POSTPONEMENTS MUST BE IN WRITING AND IN STRICT COMPLIANCE WITH BOARD RULE 2(b). NO POSTPONEMENTS WILL BE GRANTED WITHIN FIFTEEN (15) DAYS OF SCHEDULED HEARING DATE UNLESS IN FULL COMPLIANCE WITH RULE 2(c), COUNTY COUNCIL BILL NO. 59-79.

CASE NO. 89-133-A

MICHAEL E. MABRY, ET UX NW/cor Glencoe Road and Darlington Drive (2501 Glencoe Road)

9th Election District 6th Councilmanic District

VAR -Front setback of 29' and corner lot side setback of 21' in lieu of required 34.6' and 25' respectively 10/25/88 -Z.C.'s Order that Petition for Variance

Appellants /Petitioners

WEDNESDAY, MAY 3, 1989 at 10:00 a.m.

is DENIED.

cc: E. David Silverberg, Esquire Dr. & Mrs. Michael E. Mabry Pecple's Counsel for po 1) 36
Baltimore County

P. David Fields Pat Keller J. Robert Haines

Ann M. Nastarowicz James E. Dyer Docket Clerk -Zoning Arnold Jablon, County Attorney

> Kathleen C. Weidenhammer Administrative Secretary

Counsel for Appellants / Petitioners

CERTIFICATE OF POSTING ZONING DEPARTMENT OF BALTIMORE COUNTY

89-133-A

Petitioner: Michael F. Mebry, et up Location of property: NW 1cox, Clencoe & Dorling ton Oils Con property of Setitioner Posted by Date of return: 9/33/88 Number of Signe: ____/

Baltimore County Zoning Commissioner Office of Planning & Zoning Towson, Maryland 21204 494-3353 J. Robert Haines

December 8, 1988



Baltimore County Board of Appeals County Office Building, Room 315 Towson, Maryland 21204

RE: Petition for Zoning Variance NW/Corner Glencoe Road and Darlington Drive (250**)**/ Glencoe Road) 9th Election District, 6th Councilmanic District Michael E. Mabry, et ux - Petitioners Case No. 89-133-A

Please be advised that an appeal of the above-referenced case was filed in this office on November 23, 1988 by E. David Silverberg, Attorney on behalf of the Petitioner. All materials relative to the case are being forwarded herewith.

Please notify all parties to the case of the date and time of the appeal hearing when it has been scheduled. If you have any questions concerning this matter, please do not hesitate to contact this office.

Zoning Commissioner

Date: 9/22/88

post set(s), there

each set not

Dennis F. Rasmussen

JRH:cer

Enclosures

Baltimore County

J. Robert Haines

2501 Glencoe Road

Dear Mr. & Mrs. Mabry:

BALTIMORE COUNTY, MARYLAND

MISCELLANEOUS CASH RECEIPT

OFFICE OF FINANCE - REVENUE DIVISION

FOR: Post of the second


VALIDATION OR SIGNATURE OF CASHIER

Zoning Commissioner
Office of Planning & Zoning

Towson, Maryland 21204

Mr. & Mrs. Michael E. Mabry

Baltimore, Maryland 21234

Petition for Zoning Variance Case Number: 89-133-A

cc: Dr. & Mrs. Michael E. Mabry 2501 Glencoe Road, Baltimore, Md. 21234

E. David Silverberg, Wase, Lyons, & Fedock, P.A., RCM & D Building Suite 200, 555 Fairmount Avenue, Towson, Md. 21204 People's Counsel of Baltimore County

Rm. 304, County Office Bldg., Towson, Md. 21204

Please be advised that 90.00 is due for advertising and posting of the above-referenced property. All fees must be paid prior to the hearing.

ON THE DAY OF THE HEARING OR THE ORDER SHALL NOT BE ISSUED.

Do not remove the sign and post set(s) from the property from the time

Please make your check payable to Baltimore County, Maryland and bring it along with the sign(s) and post(s) to the Zoning Office, County Office

it is posted by this office until the day of the hearing itself.

Building, Room 111, Towson, Maryland 21204 fifteen (15) minutes before

WASE, LYONS & FEDOCK, P.A.

JOSEPH I WASE JOSEPH 5 LYONS MICHAEL J. FEDOCK III E DAVID SILVERBERG FRANCIS D. DeMURO STACY LOBOW SIEGEL

RCM & D BUILDING, SUITE 200 555 FAIRMOUNT AVENUE TOWSON, MARYLAND 21204 (301) 583-8300

November 16, 1988

Mr. J. Robert Haines Zoning Commissioner for Baltiore County Offie of Planning and Zoning lli W. Chesapeake Avenue Towson, Maryland 21204

> Re: Petition for Zoning Variance 2501 Glencoe Road #89-133-A

Dear Mr. Haines:

BALTIMORE COUNTY, MARYLAND

MISCELLANEOUS CASH RECEIPT

OFFICE OF FINANCE - REVENUE DIVISION

I represent Dr. and Mrs. Michael E. Mabry. They have retained me to appeal from the adverse decision in the referenced case rendered on October 25, 1988. My clients' check for \$90, payable to the Office of Finance is enclosed.

If there is any particular form for an appeal to be noted, please advise me as soon as possible.

VALIDATION OR SIGNATURE OF CASHIER

DISTRIBUTION

WHITE CASHIER PINK AGENCY YELLOW - CUSTOMER

Baltimore County Zoning Commissioner Office of Planning & Zoning Towson, Maryland 21204 494 3353

J. Robert Haines

NOTICE OF HEARING



The Zoning Commissioner of Baltimore County, by authority of the Zoning Act and Regulations of Baltimore County will hold a public hearing on the property identified herein in Room 106 of the County Office Building, located at 111 W. Chesapeake Avenue in Towson, Maryland as follows:

> Petition for Zoning Variance CASE NUMBER: 89-133-A NUC Glencoe and Carington Drive (2501 Glencoe Road) 9th Election District - 6th Councilmanic Petitioner(s): Michael E. Mabry, et ux HEARING SCHEDULED: THRUSDAY, DCTOBER 13, 1988 at 2:00 p.m.

Variance to allow a front setback of 29 ft. and a corner lot side setback of 21 feet in lieu of the required 34.5 foot front yard average and 25 feet, respectively.

In the event that this Petition is granted, a building permit may be issued within the thirty (30) day appeal period. The Zoning Commissioner will, however, entertain any request for a stay of the issuance of sai! permit during this period for good cause shown. Such request must be in writing and received in this office by the date of the hearing set above or presented at the hearing.

J. ROBERT HAINES Zoning Commissioner of Baltimore County

CC: Mr. Make

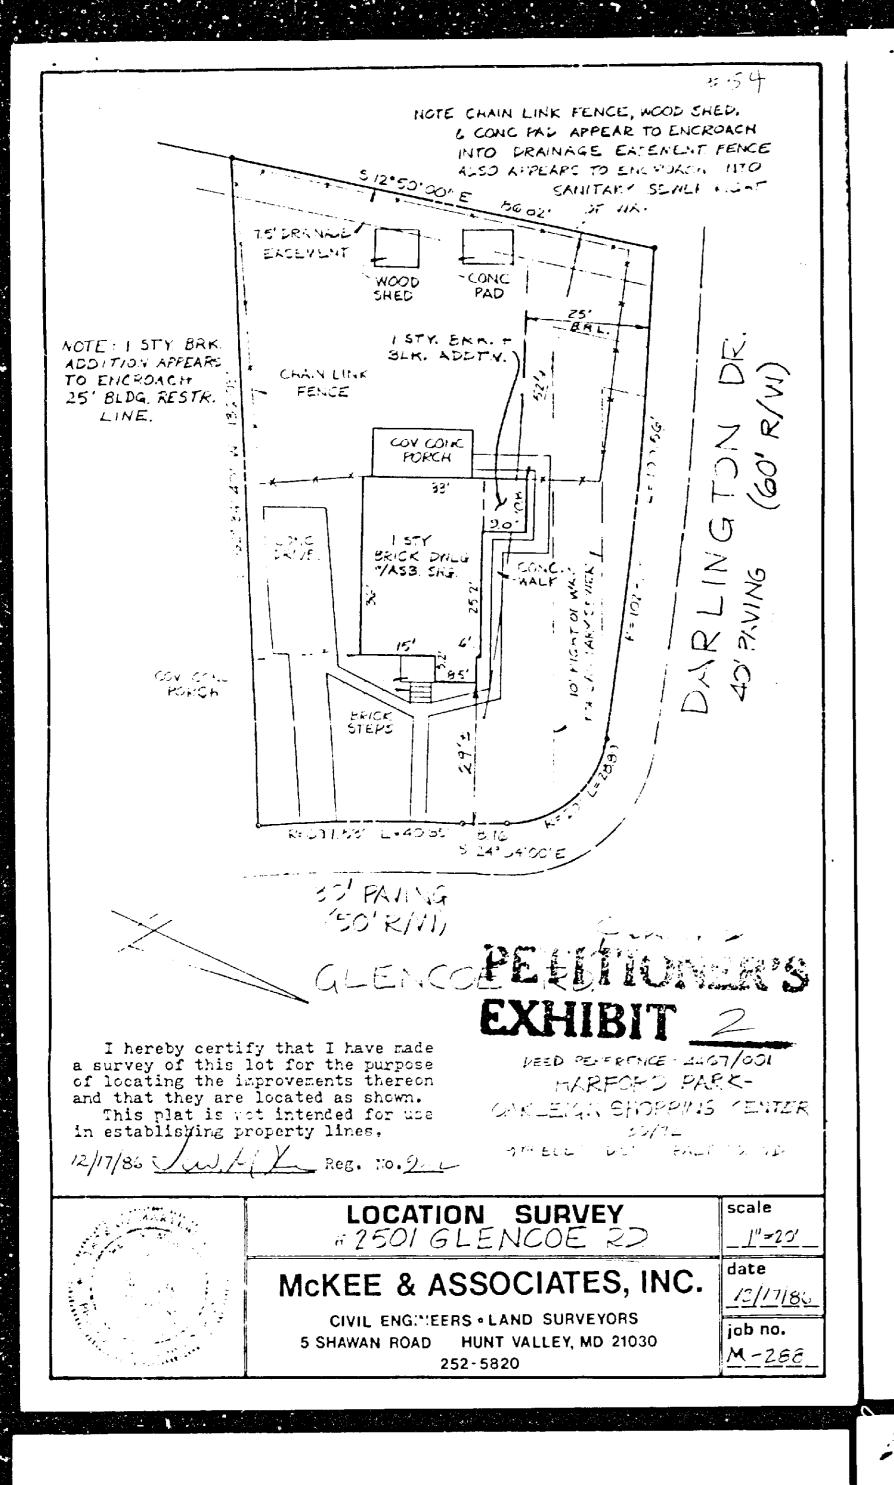


EXHIBIT 1

October 7, 1988

Mr. J. Robert Haines Zoning Commission 111 W. Chesapeake Ave. Room 109 Towson, MD 21204

Michael & Helen Mabry 602 South Lang Avenue Pittsburgh, PA 15208 412-371-5975

RE: Petition for Zoning Variance Case Number: 89-133-A Property at 2501 Glencoe Road

Dear. Commissioner Haines:

Due to my responsibilities at the University of Pittsburgh Medical School, and my wife's responsibilities at the Carnegie-Mellon School of Architecture, we will be unable to travel to Baltimore next week. We will be represented at the Zoning Commission meeting of October 13th, 1988 by Mr. Leonard Gilbert. Mr. Gilbert currently lives at 2501 Glencoe Road.

We have provided him with documents, and maps pertaining to our variance request for our property at 2501 Glencoe Road. He also has our \$90 check for the variance signs which are to be returned prior to this Zoning Commission hearing. He will also carry our "power of attorney" to act on our behalf in regard to this petition for a zoning variance.

We discovered this problem at the closing on this house in 1983. Apparently the front set-back line was declared after this house was complete many years ago. This created a retroactive encroachment of the front set-back line by the front porch. The previous owner, Ms. Laura Hetrick, made a number of improvements to the house. We have not created any further encroachments.

We are petitioning for a zoning variance not for any new construction, but instead for acknowledgement of long-standing encroachments we inherited from the previous owner.

We will gladly provide any further information that we have at our disposal. I can be reached at 412-648-3190 during business hours.

Sincerely,

Michael E. Mabry, M.D. EXHIBIT ± MAERY/PA

tacD Bldg. Suite 200

њег, МИ 21234 301,553-5300

LIMITED POWER OF ATTORNEY

I, Michael E. Mabry, of 602 S. Lang Avenue, Pittsburgh, Pennsylvania, 15208, hereby execute this Limited Power of Attorney with the intention that the attorney-in-fact hereinafter named shall be able to act in my place for the purposes set forth herein.

Section 1: Designation of Attorney. 1.01. I constitute and appoint Leonard Gilbert, 2501 Glencoe Road, Baltimore, Maryland, 21234 to be my attorney-in-fact to act formally in my name and in my place.


Section 2: Effective Date of Power of Attorney. 2.01. This Limited Power of Attorney shall be effective as of the date of its execution by me.

2.02. This Limited Power of Attorney shall not be affected by my disability, it being my specific intention that my attorney-in-fact shall continue to act as such even though I may not be competent to ratify the actions of my attorney-in-fact.


Section 3: Powers. 3.01. I authorize my attorney-in-fact, Leonard Gilbert to act in my place and stead at all hearings involving any zoning matter pertaining to the property at 2501 Glencoe Road, Baltimore, Maryland, 21234.

Section 4: Ratification.


PETITIONER'S EXHIBIT 5

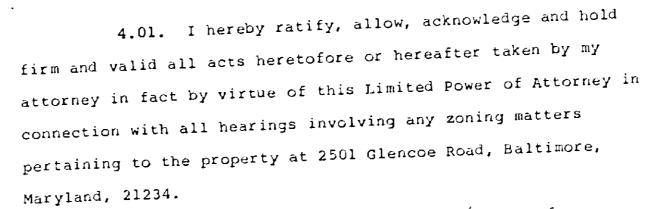

AS WITNESS, my hand and seal this 🤔 day of October, 1988.

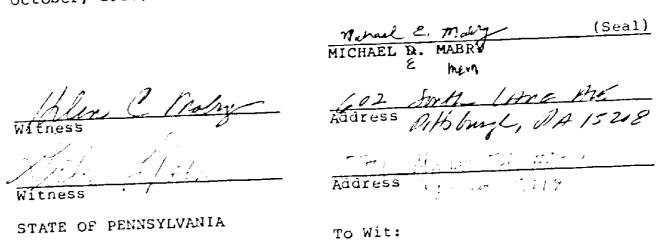


I HEREBY CERTIFY on this 🚣 day of October, 1988, before me the Subscriber, a Notary Public in and for the State E. Min aforesaid, personally appeared Michael A. Mabry and acknowledged the aforesaid Limited Power of Attorney to be his

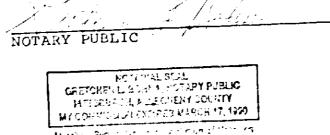

E LYONS & FEDOR K. PA. M&DBille, Suite 200 555 Fairmount Ave Tueson, MD 21204 -301/583-8300


n9 25

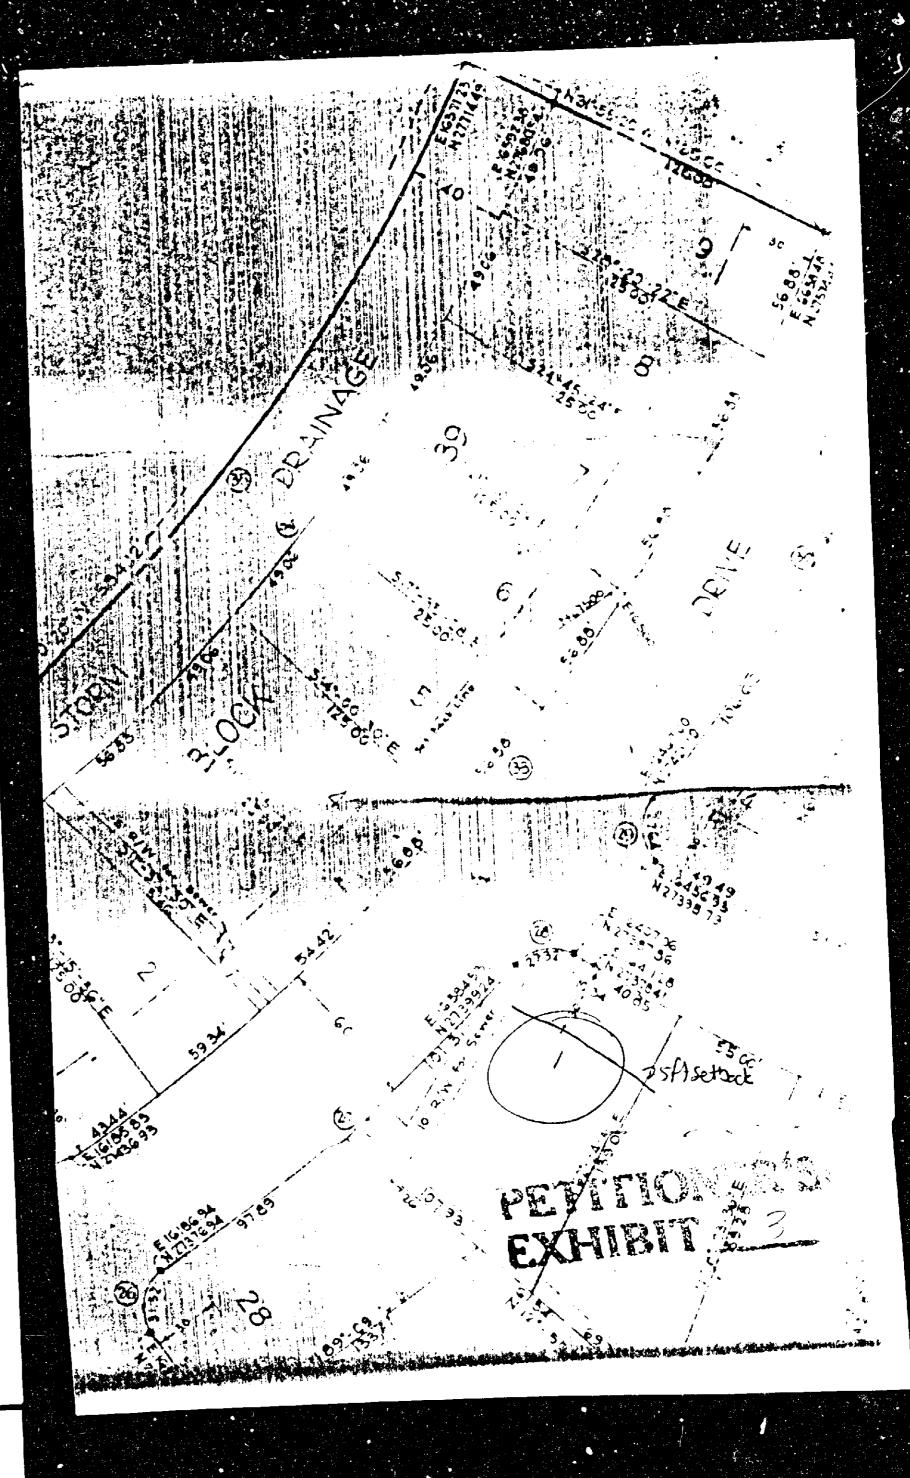


CITY/COUNTY OF


AS WITNESS, my hand and notarial seal.


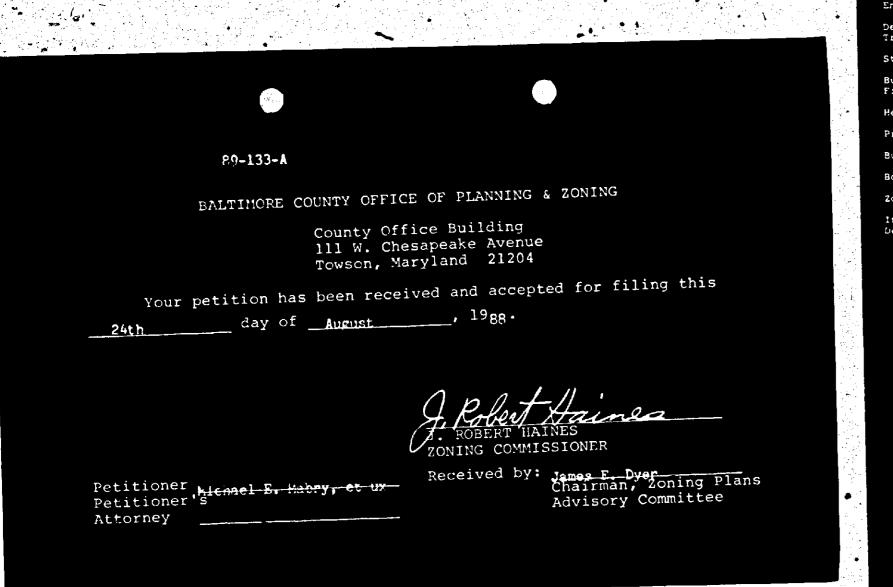

BALTIMORE COUNTY ZONING PLANS ADVISORY COMMITTEE October 3, 1988 COUNTY OFFICE BLDG. Mr. & Mrs. Michael E. Mabry 2501 Glencoe Road Baltimore, Maryland 21234 RE: Item No. 54 - Case No. 89-133-A Petitioner: Michael E. Mabry, et ux Petition for Zoning Variance Bureau of Engineering Dear Mr. & Mrs. Mabry: Department of Traffic Engineering The Zoning Plans Advisory Committee has reviewed the plans submitted with the above referenced petition. The following State Roads Commission comments are not intended to indicate the appropriateness of the Bureau of zoning action requested, but to assure that all parties are made aware of plans or problems with regard to the development plans Health Department that may have a bearing on this case. The Director of Planning may file a written report with the Zoning Commissioner with Project Planning recommendations as to the suitability of the requested zoning. Building Department Board of Education Enclosed are all comments submitted from the members of the Committee at this time that offer or request information on your Zoning Administration petition. If similar comments from the remaining members are Industrial received, I will forward them to you. Otherwise, any comment that is not informative will be placed in the hearing file. This petition was accepted for filing on the date of the enclosed filing certificate and a hearing scheduled accordingly. Very truly yours, - narra & Sugarldt JAMES E. DYER Chairman Zoning Plans Advisory Committee JED:dt

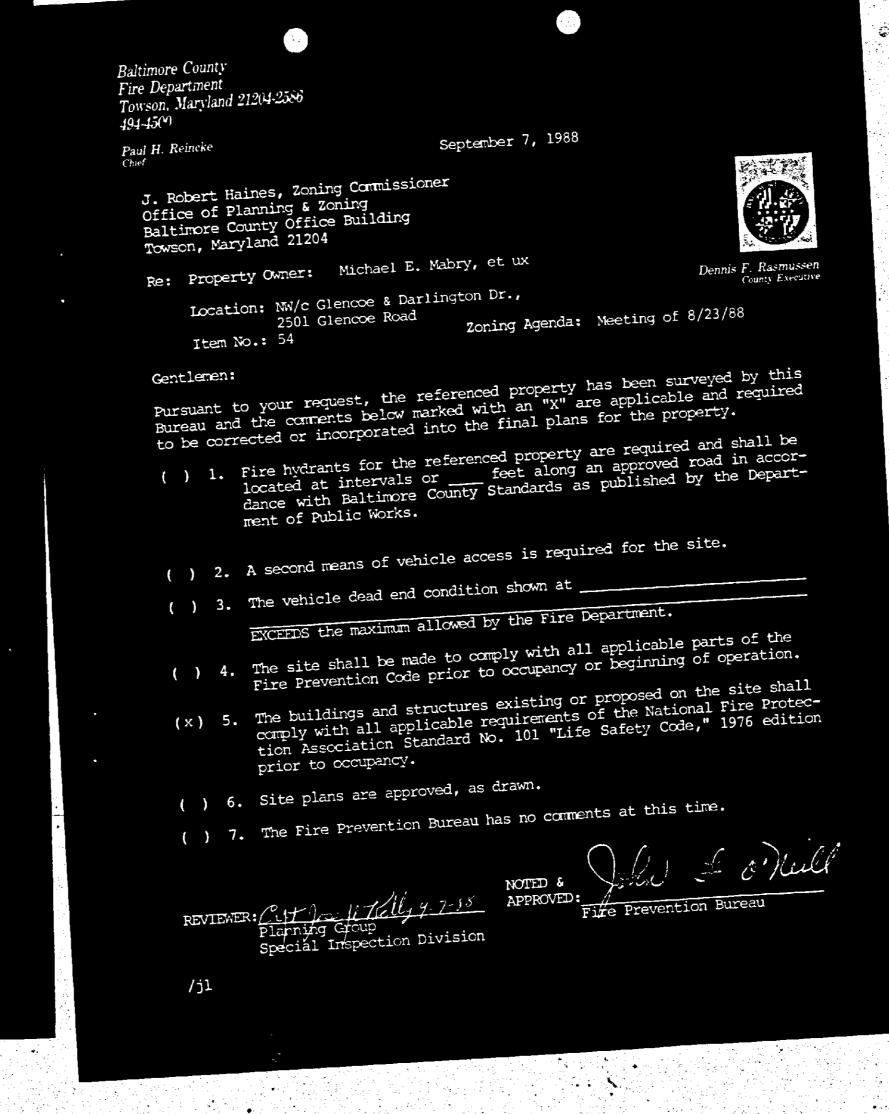

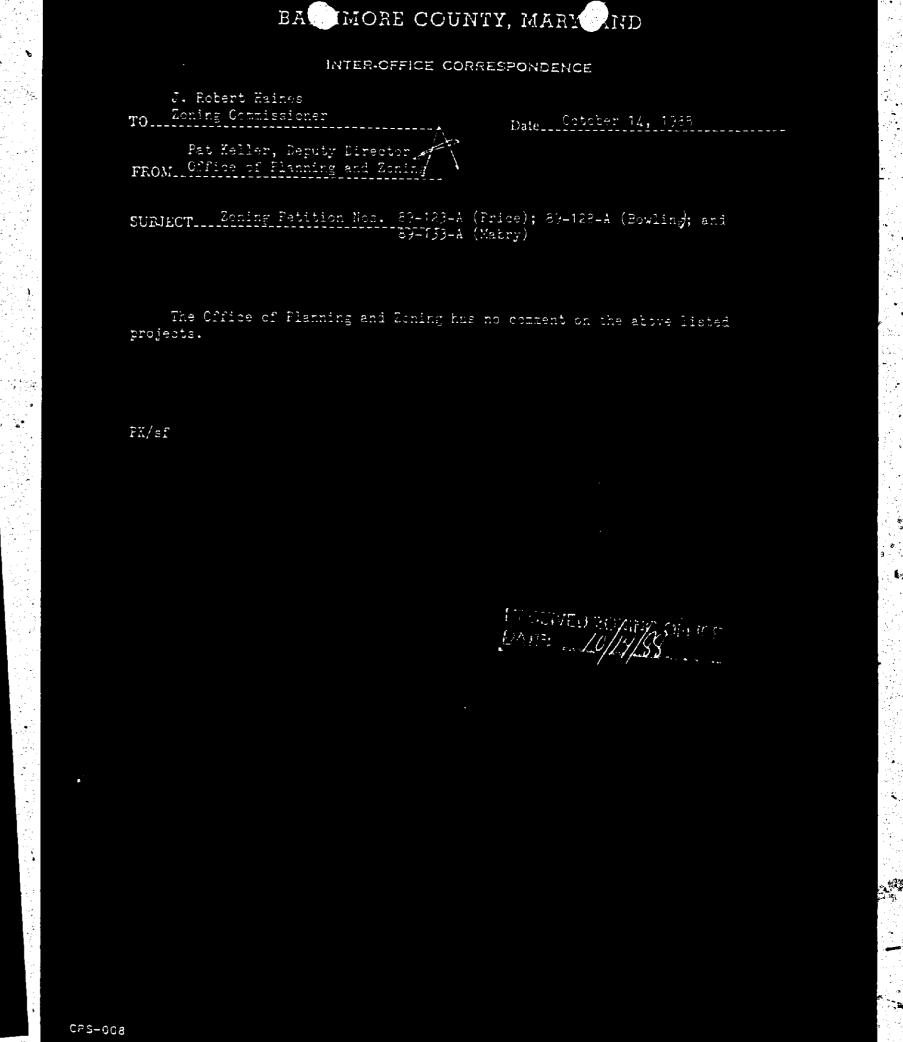

October 7, 1988 Mr. J. Robert Haines Zoning Commission 111 W. Chesapeake Ave. Raom 109 Towson, MD 21204 Michael & Helen Mabry 602 South Lang Avenue Pittsburgh, PA 15208 412-371-5975 RE: Petition for Zoning Variance Case Number: 89-133-A Property at 2501 Glencoe Road Dear. Commissioner Haines: Due to my responsibilities at the University of Pittsburgh Medical School, and my wife's responsibilities at the Carnegie-Mellon School of Architecture, we will be unable to travel to Baltimore next week. We will be represented at the Zoning Commission meeting of October 13th, 1988 by Mr. Leonard Gilbert. Mr. Gilbert currently lives at 2501 Glencoe Road. We have provided him with documents, and maps pertaining to our variance request for our property at 2501 Glencoe Road. He also has our \$90 check for the variance signs which are to be

returned prior to this Zoning Commission hearing. He will also carry our "power of attorney" to act on our behalf in regard to this petition for a zoning variance. We discovered this problem at the closing on this house in encroachment of the front set-back line by the front porch. The

previous owner, Ms. Laura Hetrick, made a number of improvements to the house. We have not created any further encroachments. We are petitioning for a zoning variance <u>not</u> for any new construction, but instead for acknowledgement of long-standing encroachments we inherited from the previous owner.

We will gladly provide any further information that we have at our disposal. I can be reached at 412-648-3190 during

Michail E. Maly M.D Michael E. Mabry, M.D.

APPEAL Petition for Zoning Variance NW/Corner Glencoe Road and Darlington Drive (2501 Glencoe Road) 9th Election District - 6th Councilmanic District MICHAEL E. MABRY, ET UX, - Petitioner Case No. 89-133-A VARIANCE - Frt. setback of 29' and corner lot side setback of 21' in lieu of the req. 34.6' frt. and 25' respectively.

Petition for Zoning Variance Description of Property Certificate of Posting Certificate of Publication Entry of Appearance of People's Counsel (None Submitted) Zoning Plans Advisory Committee Comments Director of Planning & Zoning Comments (None Submitted) Petitioner's Exhibits: 1. Plat for Zoning Variance Location Survey 3. Copy of partial record plat 4. Copy of Dr. & Mrs. Mabry's consent of Mr. Leonard Gilbert as personal representative 5. Copy of Limited Power of Attorney Zoning Commissioner's Order dated October 25, 1988 (Denied) Notice of Appeal received November 23, 1988 from E. David Silverberg, Attorney on behalf of the Petitioner. cc: Dr. & Mrs. Michael E. Mabry - 602 S. Lang are, Pittburg, *E. David Silverberg, Wase, Lyons, & Fedock, P.A., RCM & D Building Suite 200, 555 Fairmount Avenue, Towson, Md. 21204 People's Counsel of Baltimore County Out 126
Rm. 304, County Office Bldg., Towson, Md. 21204 uest Notification: P. David Fields, Director of Flanning & Zoning J. Robert Haines, Zoning Commissioner Ann M. Nastarowicz, Deputy Zoning Commissioner James E. Dyer, Zoning Supervisor Docket Clerk